




- LEGEND**
- SOLID WASTE BOUNDARY
 - GAS MONITORING PROBE
 - PIEZOMETER MONITORING WELL
 - GAS EXTRACTION WELL
 - DUAL GAS EXTRACTION WELL
 - SURFACE EXTRACTION WELL
 - PERIMETER GAS EXTRACTION WELL
 - LFG ISOLATION VALVE
 - CONDENSATE SUMP
 - LEACHATE COLLECTION SUMP
 - HORIZONTAL COLLECTION SUMP
 - PERIMETER SUMP
 - LEACHATE COLLECTION SUMP
 - SURFACE COLLECTOR
 - TEMPERATURE MONITORING PROBE
 - SUBSURFACE RCP WELLS
 - TRENCH SUMP
 - INTERCEPTION TRENCH RISERS
 - PERIMETER LEACHATE SUMP
 - WELL HEAD RISERS
 - WELL BORE BOOTS
 - TRENCH SUMP
 - OVER LINER TIE IN POINT
 - GAS INTERCEPTOR WELL
 - PHASE DESIGNATION
 - CLEAN OUT
 - QUARRY WALL
 - BURIED LFG COLLECTION PIPING
 - 2" ABOVE GROUND LFG COLLECTION PIPING
 - 4" ABOVE GROUND LFG COLLECTION PIPING
 - 6" ABOVE GROUND LFG COLLECTION PIPING
 - 8" ABOVE GROUND LFG COLLECTION PIPING
 - 10" STEEL GROUND LFG COLLECTION PIPING
 - 12" ABOVE GROUND LFG COLLECTION PIPING
 - 18" ABOVE GROUND LFG COLLECTION PIPING
 - FENCE LINE
 - AIR LINE
 - 2" LEACHATE COLLECTION PIPING
 - 4" LEACHATE COLLECTION PIPING
 - 4" X 8" DUAL CONTAINED LEACHATE COLLECTION PIPING
 - 2" X 4" DUAL CONTAINED LEACHATE COLLECTION PIPING
 - UNDERGROUND ELECTRIC LINE
 - NATURAL GAS LINE
 - WATERMAIN
 - BUBBLE SUCKER
 - TOE DRAIN
 - 4" PERFORATED TRENCH DRAIN
 - INTERCEPTION TRENCH
 - BUILDING

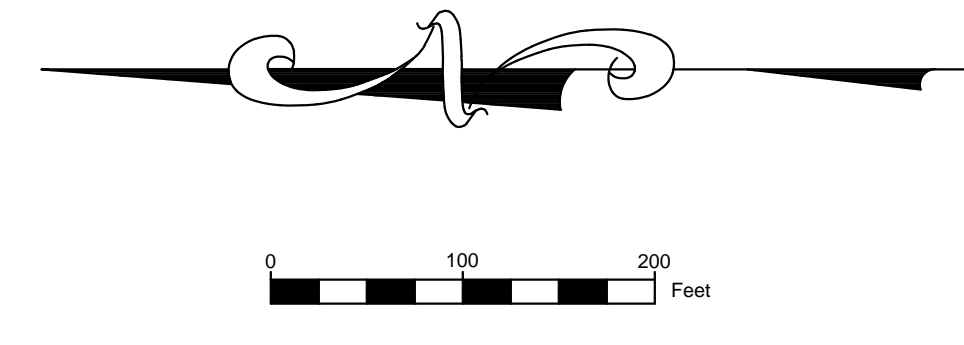

NOTE: SEVERAL SIGNIFICANT PROJECTS ARE CURRENTLY UNDER CONSTRUCTION AT SITE. AS-BUILTS TO BE SUBMITTED UPON COMPLETION AND CERTIFICATION.

BRIDGETON LANDFILL, LLC 13070 ST. CHARLES ROCK ROAD BRIDGETON, MISSOURI 63044	BRIDGETON LANDFILL SITE INFRASTRUCTURE		NOVEMBER 2013	DRAWING NO.:
			DESIGNED BY: PML	001
SITE INFRASTRUCTURE PLAN			APPROVED BY:	
			Dec. 2013	PML
			Jan. 2013	PML
PROJECT NUMBER: BT-015 FILE PATH: C:\Users\Paul\Documents\Bridgeton\BT-015\Drawings\Site Infrastructure Site Plan.dwg			REVISION	DATE